


SOME SURVEYING MEASUREMENTS NOT TAKEN
WHILE STUDENT TEAM WAS ON-SITE

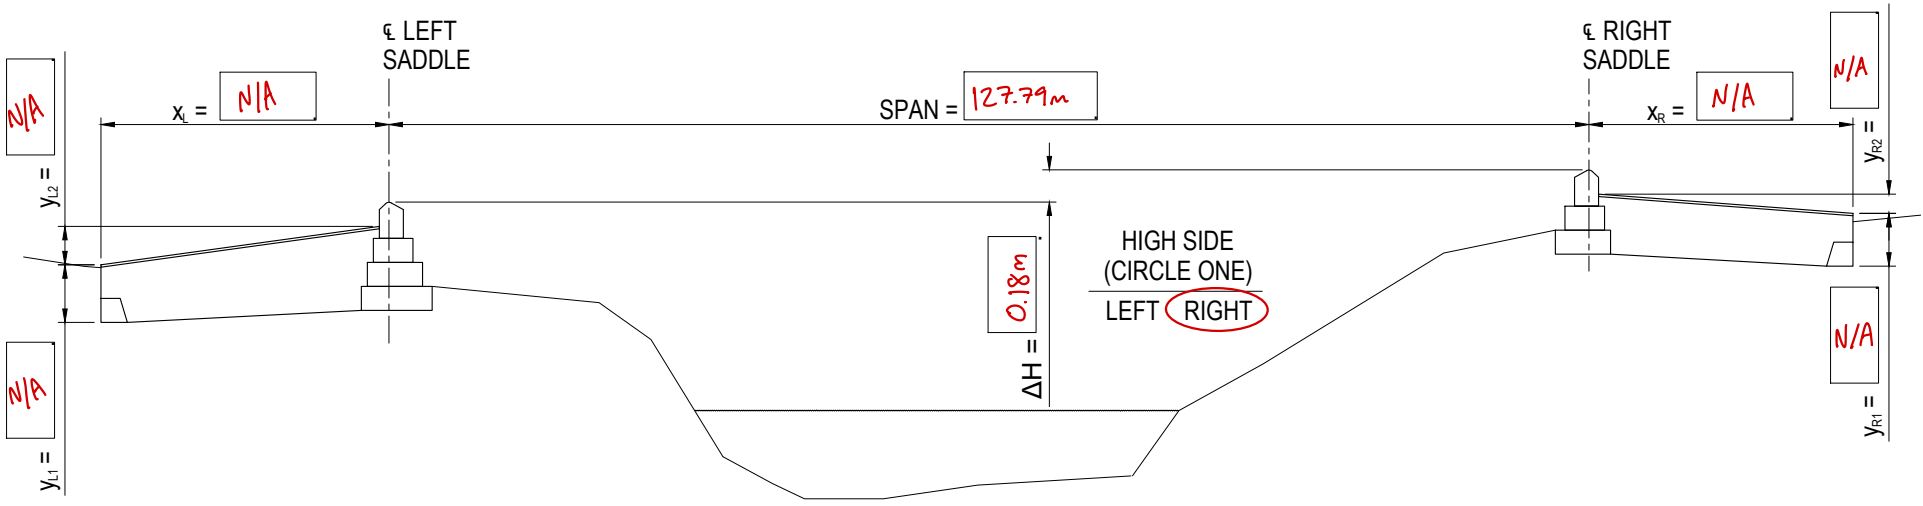

ELEVATION

f VALUE CALCULATION

	HOIST	DEAD LOAD
SPAN	127.79m	127.79m
SAG PERCENTAGE (FROM DRAWINGS) x	3.97%	4.55%
h =	5.07m	5.81m
$f_{LOW} = \frac{(4 * h - \Delta H)^2}{16 * h}$	4.99m	5.73m
ACTUAL f_{LOW} (SURVEYED)	N/A	5.38m

LEGEND:

- SPAN = HORIZONTAL DISTANCE FROM CENTERLINE OF SADDLE (L) TO CENTERLINE OF SADDLE (R)
- ΔH = VERTICAL DISTANCE FROM TOP OF TOWER (L) TO TOP OF TOWER (R)
- x_L = HORIZONTAL DISTANCE FROM CENTERLINE OF SADDLE (L) TO BACK OF ABUTMENT/ANCHOR (L)
- y_{L1} = VERTICAL DISTANCE FROM TOP OF END OF RAMP (L) TO BOTTOM OF ANCHOR (L)
- y_{L2} = VERTICAL DISTANCE FROM TOWER WALKWAY (L) TO TOP OF END OF RAMP (L)
- x_R = HORIZONTAL DISTANCE FROM CENTERLINE OF SADDLE (R) TO BACK OF ABUTMENT/ANCHOR (R)
- y_{R1} = VERTICAL DISTANCE FROM TOP OF END OF RAMP (R) TO BOTTOM OF ANCHOR (R)
- y_{R2} = VERTICAL DISTANCE FROM TOWER WALKWAY (R) TO TOP OF END OF RAMP (R)



Produced by:
Bridges to Prosperity
1031 33rd Street, Suite 170
Denver, CO 80205
Revision : July 2019

COPYRIGHT: MATERIAL FROM THIS PUBLICATION MAY BE FREELY QUOTED, TRANSLATED OR OTHERWISE USED. ANY MODIFICATIONS MUST BE APPROVED BY BRIDGES TO PROSPERITY'S DESIGN TEAM.

DISCLAIMER: THE CALCULATIONS AND INTERPRETATIONS IN THE PLAN ARE NOT ATTRIBUTABLE TO BRIDGES TO PROSPERITY AND ANYONE USING THIS PLAN SHOULD VERIFY THE CALCULATIONS ACCORDING TO SITE SPECIFIC CONDITIONS AND LOCAL STANDARDS. ALL USING THE MANUAL AGREE TO HOLD BRIDGES TO PROSPERITY HARMLESS TO ANY AND ALL LIABILITY.

EDITED AND PUBLISHED BY: BRIDGES TO PROSPERITY, INC., 2017

**SUSPENDED BRIDGE
AS-BUILT SURVEY**

DRAWING NUMBER

NYAKUZA SUSPENDED BRIDGE

GPS COORDINATES 27°07'41.46"S, 31°28'35.62"E
 COUNTRY ESWATINI
 REGION SHISELWENI
 INKHUNDLA HOSEA
 COMMUNITY EMANYONYANENI, NSIZATJE
 SPAN 127.84 METERS

DESIGN DATA:

ENGINEERS IN ACTION, 2024 BRIDGE BINDER VOLUME 2.

DESIGN LOADS:
 DEAD LOAD = 0.795 kN/m²
 LIVE LOAD_{PRIMARY} = 3.27 kN/m²
 LIVE LOAD_{SECONDARY} = 4.27 kN/m²
 WIND LOAD = 0.43 kN/m

MATERIAL PROPERTIES:
 CONCRETE f_c = 15 MPa (2200 psi)
 REINFORCING F_y = 275 MPa (40 ksi)
 TIMBER F_b = 3.96 MPa (574 psi)
 TIMBER F_v = 1.44 MPa (210 psi)
 SOIL q_a = 144 kPa (3000 psf)
 FRICTION ANGLE Ø = 30 degrees
 CABLE P_n = 604 kN (136 kips)
 CROSSBEAM STEEL F_y = 355 MPa (50 ksi)

UNIT WEIGHTS:
 STEEL = 7850 kg/m³ (490 lb/ft³)
 CONCRETE = 2400 kg/m³ (150 lb/ft³)
 TIMBER = 900 kg/m³ (56 lb/ft³)
 BROKEN ROCK = 2000 kg/m³ (125 lb/ft³)
 MASONRY = 2100 kg/m³ (131 lb/ft³)
 SOIL = 1800 kg/m³ (112 lb/ft³)

FACTOR OF SAFETY FOR SLIDING AND UPLIFT = 1.5
 FACTOR OF SAFETY FOR CABLE CAPACITY = 3.0

DECK SHALL CLEAR FREEBOARD ENVELOPE WITH A MINIMUM FREEBOARD OF 2.5 METERS.

PROVIDE 7 DROP FORGED CABLE CLAMPS SPACED AT 16 cm OC. MAX TORQUE TO 360 ft-lb. PER HANDRAIL CABLE AT EACH ANCHOR.
 PROVIDE 7 DROP FORGED CABLE CLAMPS SPACED AT 16 cm OC. MAX TORQUE TO 360 ft-lb. FOR THE WALKWAY CABLE AT EACH ANCHOR.

GENERAL NOTES:

BRIDGE CONSTRUCTION SHALL BE EXECUTED BY THE MEANS AND METHODS STATED IN THE ENGINEERS IN ACTION, 2024 BRIDGE BINDER VOLUME 3.

CONCRETE:
 PORTLAND CEMENT (ASTM C150, TYPE I OR TYPE II) SHALL BE USED. CEMENT MUST BE USED WITHIN 60 DAYS OF PURCHASE.
 WATER SHALL BE CLEAN, CLEAR, AND FREE OF HARMFUL MATERIAL.
 COARSE AGGREGATE SHALL BE COMPRISED OF GRAVEL (CRUSHED LIMESTONE, GRANITE, OR GRAVEL), NO GREATER THAN 2.5 cm IN DIAMETER. MATERIAL SHALL BE CLEAN AND FREE OF DEBRIS.
 FINE AGGREGATE SHALL BE CLEAN, DRY SAND GRADED WITH A 4mm SIEVE BEFORE MIXING WITH CEMENT.

REINFORCEMENT:
 ALL REINFORCEMENT SHALL BE MINIMUM GRADE 280 (GRADE 40) WITH A YIELD STRENGTH OF 275 MPa (40 ksi).
 RIBBED STEEL SHALL BE USED FOR ALL REINFORCING BARS INCLUDING SUSPENDERS.
 ALL REINFORCEMENT SHALL BE SUPPORTED BY CONCRETE BLOCKS OR STEEL CHAIRS TO AVOID CONTACT WITH GROUND OR FORMS.



MASONRY:
 BLOCKS SHALL BE FREE OF CRACKS AND CHIPS. THERE SHALL BE NO DEFORMATIONS. USED BLOCK IS NOT PERMITTED.
 MASONRY UNITS SHALL BE WET BEFORE APPLYING MORTAR.
 MAINTAIN A CONSISTENT JOINT THICKNESS OF 15mm+/- 5mm. JOINTS BETWEEN BLOCKS SHALL BE COMPLETELY FILLED.
 STAGGER BLOCKS IN RUNNING BOND PATTERN.


CABLE:
 CABLE IN PERMANENT CONTACT WITH THE GROUND SHALL BE COVERED WITH PLASTIC PIPE AND FILLED WITH GROUT OR COATED WITH TAR.
 CLAMPS SHALL BE DROP FORGED AND NOT MALLEABLE.

TIMBER:
 TIMBER SHALL BE FREE OF KNOTS, HOLES, AND SPLITS.
 WOOD SCREWS AND NAILS SHALL BE GALVANIZED.


INDEX:

- 1 TITLE
- 2 LAYOUT
- 3 2G-120B LEFT ABUTMENT DETAILS
- 4 2G-120A RIGHT ABUTMENT DETAILS
- 5 A7 ANCHOR DETAILS
- 6 T2 TOWER DETAILS
- 7 W3E WALKWAY DETAILS W/ OR W/O NAILER
- 8 C5E(a) CROSSBEAM DETAILS (CUSTOM)
- 9 ~~E2E~~ ~~F3~~ FENCING DETAILS
- 10 ~~D1~~ ~~D4~~ DRAINAGE DETAILS

 	REV.	DESCRIPTION	DATE	ISSUED BY	<small>DISCLAIMER: THESE DRAWINGS ARE PRODUCED FOR THE STATED BRIDGE PROJECT. ANY CONDITIONS THAT REQUIRE CHANGES FROM THE PLANS MUST BE COMMUNICATED TO THE ENGINEER FOR APPROVAL PRIOR TO CONSTRUCTION. ANYONE USING THIS PLAN SHOULD VERIFY THE CALCULATIONS ACCORDING TO SITE SPECIFIC CONDITIONS AND LOCAL STANDARDS. USE OF THESE PLANS FOR ANY OTHER PURPOSE SHALL NOT BE ATTRIBUTABLE TO ENGINEERS IN ACTION AND USERS AGREE TO HOLD ENGINEERS IN ACTION HARMLESS TO ANY AND ALL LIABILITY.</small>	COUNTRY: ESWATINI	PROJECT: NYAKUZA	ENGINEERING RECORD	NYAKUZA SUSPENDED BRIDGE TITLE	
	1	ISSUED FOR REVIEW	30-01-2025	MAS		REGION: SHISELWENI	PROGRAM MANAGER: ANA JOVANOVIC	DATE: 14/01/2025		
	2	ISSUED FOR RC2				INKHUNDLA: HOSEA		CHECKED BY: XXX	BSZ-BP117	1
								APPROVED BY: XXX		
								REVIEWED BY: XXX		

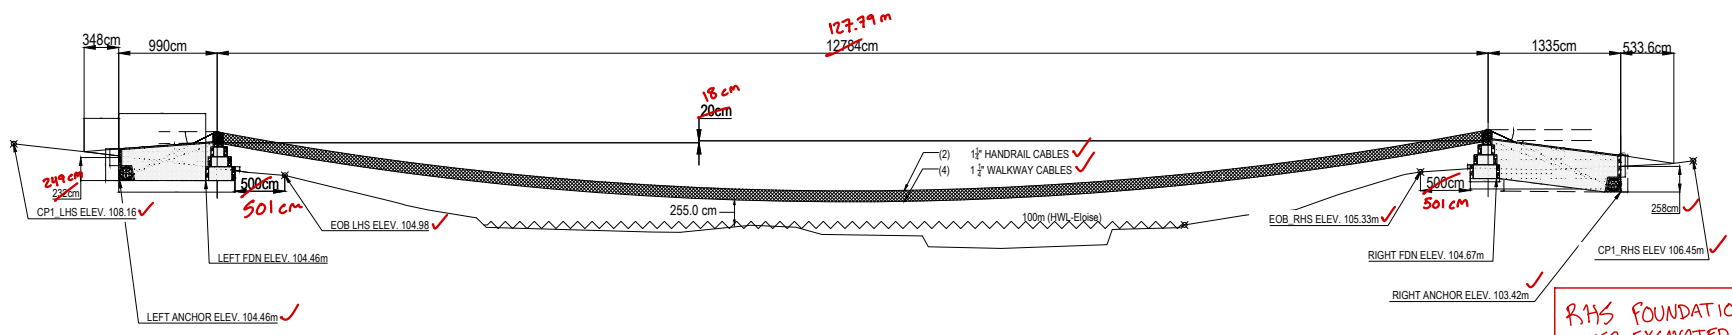

ELEVATION

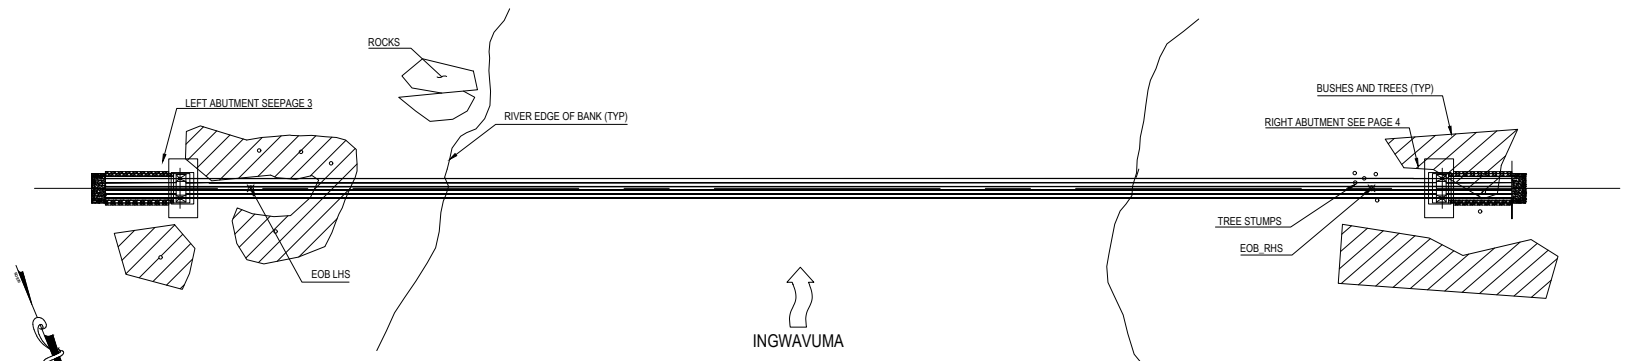

PLAN

- NOTES:
- DESIGN SAG: 5.82m (4.55%) **5.47 (4.28%)**
 - HOISTING SAG: 5.08m (3.97%)
 $f_{LEFT} = 5.18m$ $f_{RIGHT} = 4.98m$
 - CONSTRUCTION SAG: 3.84m (3.00%)
 $f_{LEFT} = 3.94m$ $f_{RIGHT} = 3.73m$
 - LIVE LOAD SAG: 7.40m (5.79%)
 - SURVEY INFORMATION PROVIDED BY SIBO ET AL. ON 25/3/2025.
 - LANDMARKS INCLUDED IN PLAN VIEW ARE FOR INFORMATION ONLY, ARE NOT DRAWN TO SCALE, AND IN APPROXIMATE LOCATIONS.



REV.	DESCRIPTION	DATE	ISSUED BY
1	ISSUED FOR REVIEW	30-01-2025	MAS
2	ISSUED FOR RC2	3-8-2025	MAS





DISCLAIMER:
 THESE DRAWINGS ARE PRODUCED FOR THE STATED BRIDGE PROJECT. ANY CONDITIONS THAT REQUIRE CHANGES FROM THE PLANS MUST BE COMMUNICATED TO THE ENGINEER FOR APPROVAL PRIOR TO CONSTRUCTION. ANYONE USING THIS PLAN SHOULD VERIFY THE CALCULATIONS ACCORDING TO SITE SPECIFIC CONDITIONS AND LOCAL STANDARDS.
 USE OF THESE PLANS FOR ANY OTHER PURPOSE SHALL NOT BE ATTRIBUTABLE TO ENGINEERS IN ACTION AND USERS AGREE TO HOLD ENGINEERS IN ACTION HARMLESS TO ANY AND ALL LIABILITY.

COUNTRY: ESWATINI
 REGION: SHISELWENI
 INKHUNDLA: HOISEA
 PROJECT: NYAKUZA
 PROGRAM MANAGER: ANA JOVANOVIC

ENGINEERING RECORD
 DATE: 3/8/2025
 DRAWN BY: MAS
 CHECKED BY: EB
 APPROVED BY: XXX
 REVIEWED BY: XXX

NYAKUZA SUSPENDED BRIDGE LAYOUT	
PROJECT NUMBER	DRAWING NUMBER
BSZ-BP117	2

ASBUILT 08/09/2025 Newry

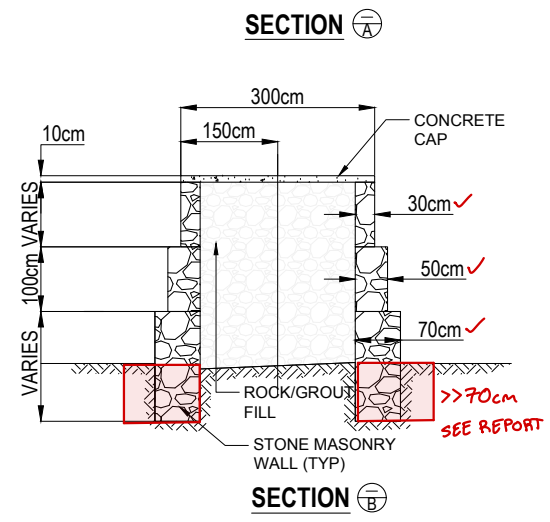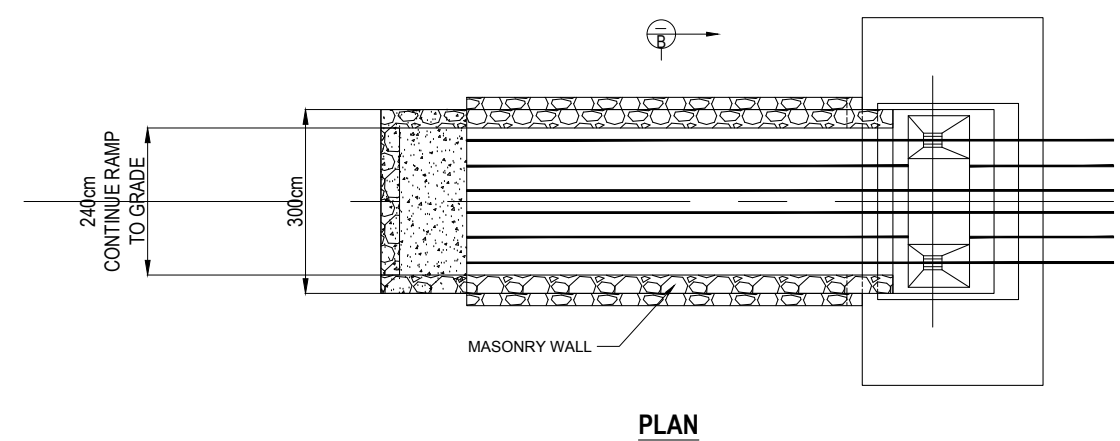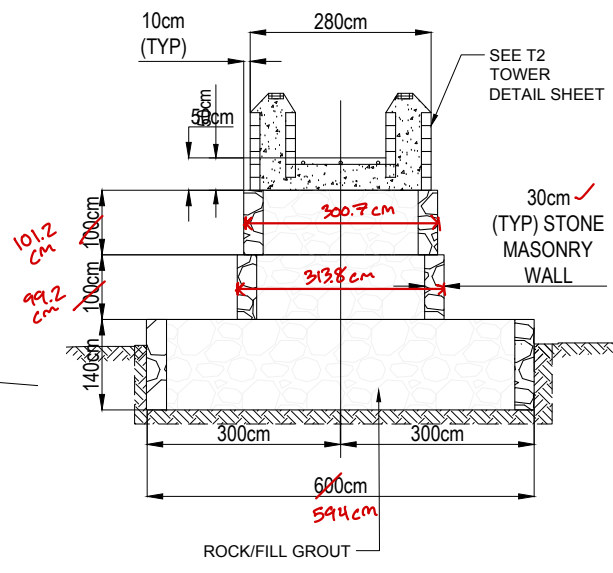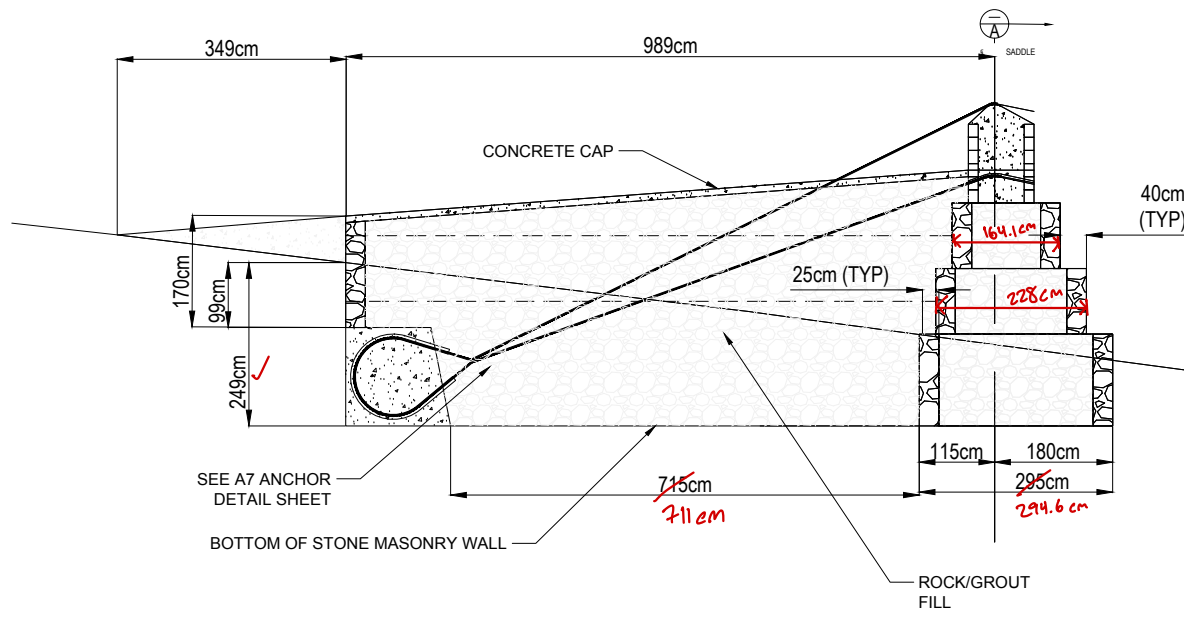


REV.	DESCRIPTION	DATE	ISSUED BY	DISCLAIMER:
1	ISSUED FOR RC2	3-08-2025	MAS	THESE DRAWINGS ARE PRODUCED FOR THE STATED BRIDGE PROJECT. ANY CONDITIONS THAT REQUIRE CHANGES FROM THE PLANS MUST BE COMMUNICATED TO THE ENGINEER FOR APPROVAL PRIOR TO CONSTRUCTION. ANYONE USING THIS PLAN SHOULD VERIFY THE CALCULATIONS ACCORDING TO SITE SPECIFIC CONDITIONS AND LOCAL STANDARDS.
				USE OF THESE PLANS FOR ANY OTHER PURPOSE SHALL NOT BE ATTRIBUTABLE TO ENGINEERS IN ACTION AND USERS AGREE TO HOLD ENGINEERS IN ACTION HARMLESS TO ANY AND ALL LIABILITY.

COUNTRY: ESWATINI
 REGION: SHISLWENI
 INKHUNDLA: HOISEA


PROJECT: NYAKUZA
 PROGRAM MANAGER: ANA JOVANOVIC

ENGINEERING RECORD
 DATE: 3/08/2025
 DRAWN BY: MAS
 CHECKED BY: EB
 APPROVED BY: XXX
 REVIEWED BY: XXX


NYAKUZA SUSPENDED BRIDGE LEFT ABUTMENT	
PROJECT NUMBER	DRAWING NUMBER
BSZ-BP117	3

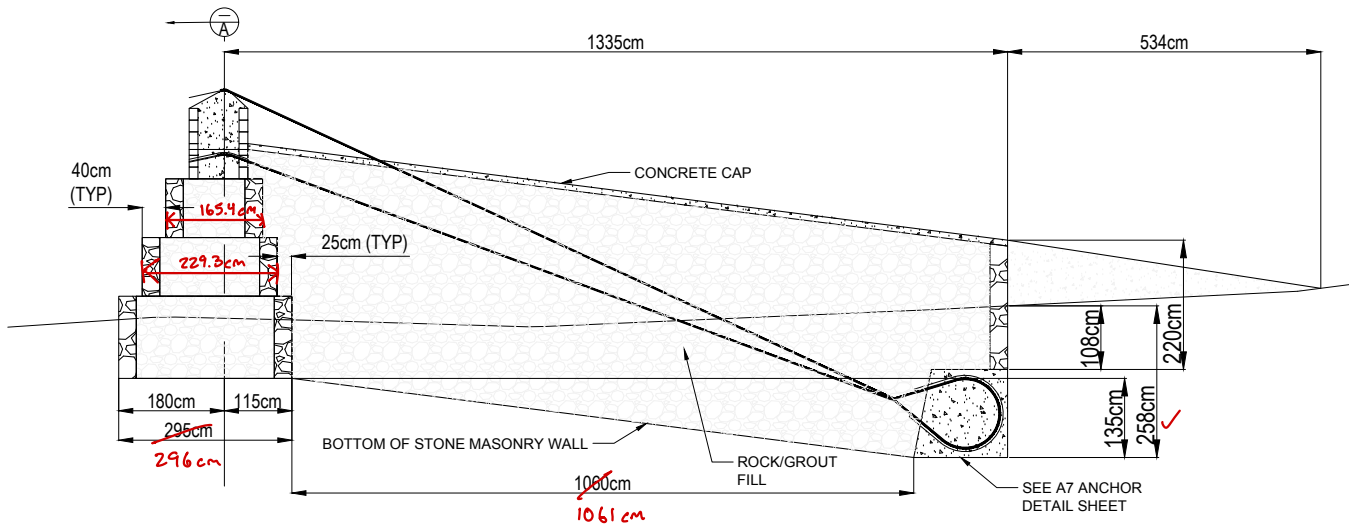


ELEVATION

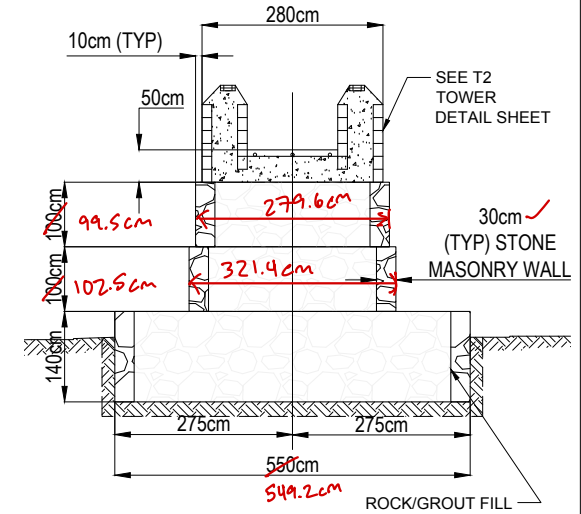

SECTION A-A

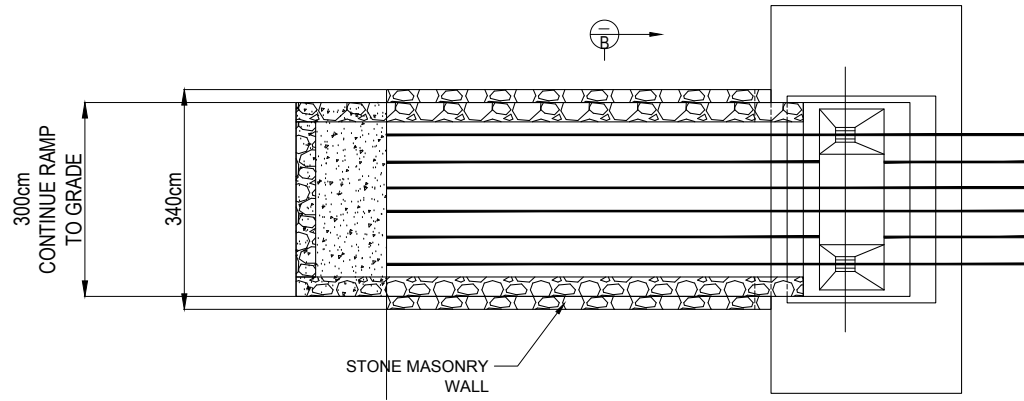

PLAN

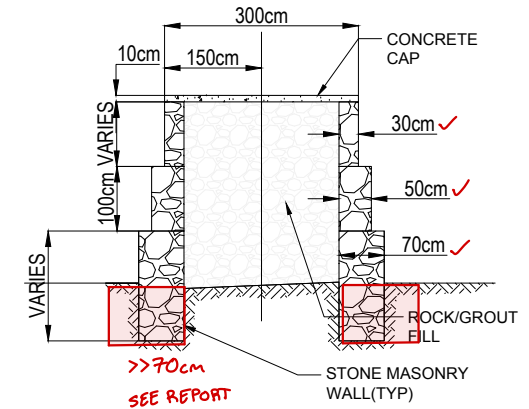

SECTION B-B



REV.	DESCRIPTION	DATE	ISSUED BY	DISCLAIMER:
1	ISSUED FOR RC2	3-08-2025	MAS	THESE DRAWINGS ARE PRODUCED FOR THE STATED BRIDGE PROJECT. ANY CONDITIONS THAT REQUIRE CHANGES FROM THE PLANS MUST BE COMMUNICATED TO THE ENGINEER FOR APPROVAL PRIOR TO CONSTRUCTION. ANYONE USING THIS PLAN SHOULD VERIFY THE CALCULATIONS ACCORDING TO SITE SPECIFIC CONDITIONS AND LOCAL STANDARDS.
				USE OF THESE PLANS FOR ANY OTHER PURPOSE SHALL NOT BE ATTRIBUTABLE TO ENGINEERS IN ACTION AND USERS AGREE TO HOLD ENGINEERS IN ACTION HARMLESS TO ANY AND ALL LIABILITY.


COUNTRY: ESWATINI
 REGION: SHISELWENI
 HOISEA

PROJECT: NYAKUZA
 PROGRAM MANAGER: ANA JOVANOVIC

ENGINEERING RECORD
 DATE: 3/08/2025
 DRAWN BY: MAS
 CHECKED BY: EB
 APPROVED BY: XXX
 REVIEWED BY: XXX

NYAKUZA SUSPENDED BRIDGE RIGHT ABUTMENT	
PROJECT NUMBER	DRAWING NUMBER
BSZ-BP117	4

LEFT ANCHOR

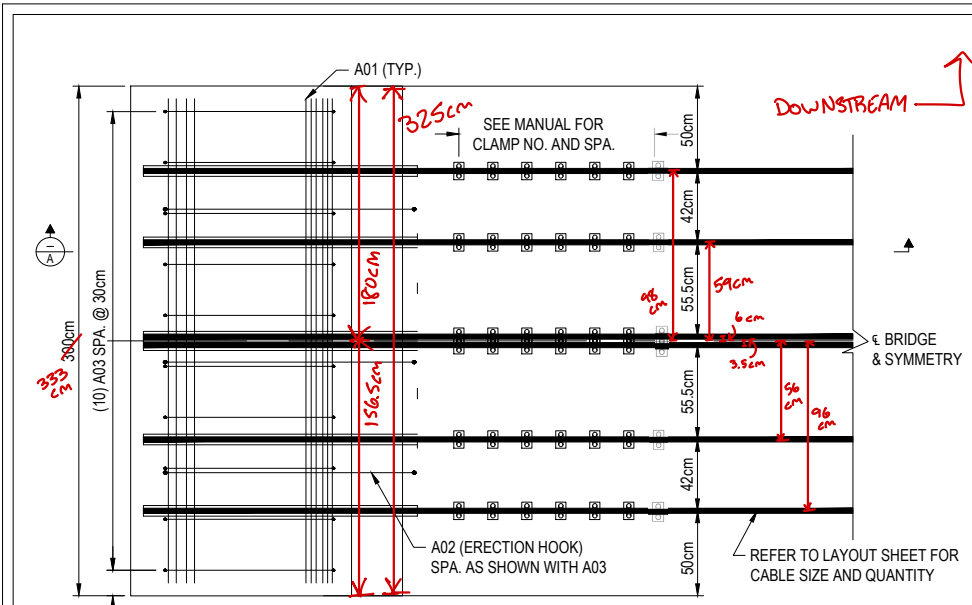



BILL OF MATERIALS

REINFORCING BARS (PER ANCHOR)				
NAME	BAR SIZE (mm)	LENGTH (cm)	QUANTITY	LENGTH (m)
A01	19 (#6)	285	10	28.5
A02	16 (#5)	326	3	9.8
A03	13 (#4)	365	10	36.5

ITEM	QUANTITY
CONCRETE	6.53m ³
FLEXIBLE PLASTIC TUBING x 400cm	VARIABLES

CLAMP SPACING AND TORQUE REQUIREMENTS

CABLE SIZE	NUMBER OF CLAMPS	SPACING		TORQUE REQUIREMENTS (ft-lb)
		(in.)	(cm)	
1	25	5		225
1-1/8	29	6	14	225
1-1/4	32	7	15	360
1-3/8	35	7	16	360

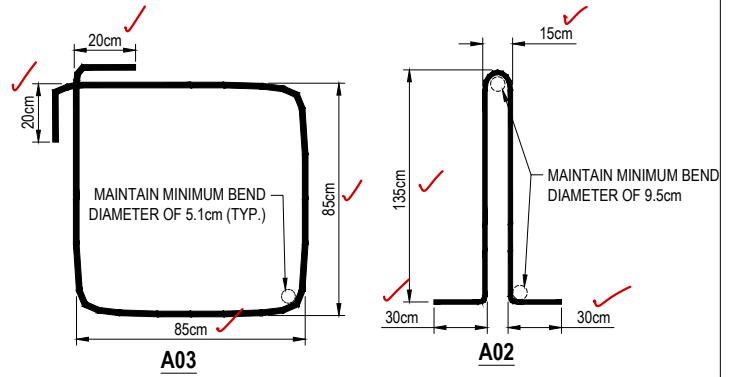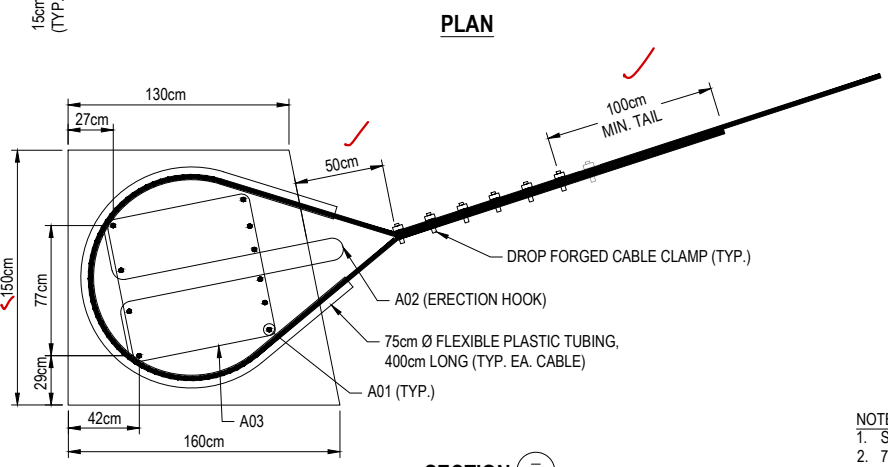

- NOTES:
- SEE ENGINEERS IN ACTION BRIDGE BINDER FOR CONSTRUCTION GUIDELINES.
 - 7.5cm CLEAR COVER SHALL BE PROVIDED FOR ALL REINFORCING AND PLASTIC TUBING.
 - ERECTION HOOK AND TUBING OPTIONAL FOR ANCHOR DETERMINED TO BE NON-ADJUSTABLE OR FIXED.
 - REINFORCING BAR DIMENSIONS ARE TAKEN TO OUTSIDE OF BAR.
 - IF USING GREATER THAN 4 WALKWAY CABLES, FOLLOW CABLE GEOMETRY ON TOWER DETAILS.



REV.	DESCRIPTION	DATE	ISSUED BY	DISCLAIMER:
0	ISSUED FOR CONSTRUCTION	04/11/2022	BKK	THESE DRAWINGS ARE PRODUCED FOR THE STATED BRIDGE PROJECT. ANY CONDITIONS THAT REQUIRE CHANGES FROM THE PLANS MUST BE COMMUNICATED TO THE ENGINEER FOR APPROVAL PRIOR TO CONSTRUCTION. ANYONE USING THIS PLAN SHOULD VERIFY THE CALCULATIONS ACCORDING TO SITE SPECIFIC CONDITIONS AND LOCAL STANDARDS.
1	UPDATED BEND DIM.	10/7/2023	BKK	
2	ADDED CLAMP TABLE	13/11/2023	BKK	

USE OF THESE PLANS FOR ANY OTHER PURPOSE SHALL NOT BE ATTRIBUTABLE TO ENGINEERS IN ACTION AND USERS AGREE TO HOLD ENGINEERS IN ACTION HARMLESS TO ANY AND ALL LIABILITY.

ENGINEERING RECORD		ANCHOR DETAILS	
DATE: 13/11/2023		100-120 METER SPAN	
DRAWN BY: BKK		4 WALKWAY CABLES	
CHECKED BY:	PROJECT NUMBER	DRAWING NUMBER	
APPROVED BY:		A7	
REVIEWED BY:			

RIGHT ANCHOR

PLAN

SECTION A-A

BILL OF MATERIALS

REINFORCING BARS (PER ANCHOR)				
NAME	BAR SIZE (mm)	LENGTH (cm)	QUANTITY	LENGTH (m)
A01	19 (#6)	285	10	28.5
A02	16 (#5)	326	3	9.8
A03	13 (#4)	365	10	36.5

ITEM	QUANTITY
CONCRETE	6.53m ³
FLEXIBLE PLASTIC TUBING x 400cm	VARIES

CLAMP SPACING AND TORQUE REQUIREMENTS				
CABLE SIZE		NUMBER OF CLAMPS	SPACING	TORQUE REQUIREMENTS (ft-lb)
(in.)	(mm)		(in.) (cm)	
1	25	5	6 14	225
1-1/8	29	6	6 15	225
✓ 1-1/4	32	7 ✓	6 16 ✓	360 ✓
1-3/8	35	7	6 16	360

NOTES:

- SEE ENGINEERS IN ACTION BRIDGE BINDER FOR CONSTRUCTION GUIDELINES.
- 7.5cm CLEAR COVER SHALL BE PROVIDED FOR ALL REINFORCING AND PLASTIC TUBING.
- ERECTION HOOK AND TUBING OPTIONAL FOR ANCHOR DETERMINED TO BE NON-ADJUSTABLE OR FIXED.
- REINFORCING BAR DIMENSIONS ARE TAKEN TO OUTSIDE OF BAR.
- IF USING GREATER THAN 4 WALKWAY CABLES, FOLLOW CABLE GEOMETRY ON TOWER DETAILS.

ENGINEERS IN ACTION

REV.	DESCRIPTION	DATE	ISSUED BY
0	ISSUED FOR CONSTRUCTION	04/11/2022	BKK
1	UPDATED BEND DIM.	10/7/2023	BKK
2	ADDED CLAMP TABLE	13/11/2023	BKK

DISCLAIMER: THESE DRAWINGS ARE PRODUCED FOR THE STATED BRIDGE PROJECT. ANY CONDITIONS THAT REQUIRE CHANGES FROM THE PLANS MUST BE COMMUNICATED TO THE ENGINEER FOR APPROVAL PRIOR TO CONSTRUCTION. ANYONE USING THIS PLAN SHOULD VERIFY THE CALCULATIONS ACCORDING TO SITE SPECIFIC CONDITIONS AND LOCAL STANDARDS.

USE OF THESE PLANS FOR ANY OTHER PURPOSE SHALL NOT BE ATTRIBUTABLE TO ENGINEERS IN ACTION AND USERS AGREE TO HOLD ENGINEERS IN ACTION HARMLESS TO ANY AND ALL LIABILITY.

ENGINEERING RECORD

DATE: 13/11/2023

DRAWN BY: BKK

CHECKED BY:

APPROVED BY:

REVIEWED BY:


ANCHOR DETAILS

100-120 METER SPAN


4 WALKWAY CABLES

PROJECT NUMBER	DRAWING NUMBER
	A7

LEFT TOWER

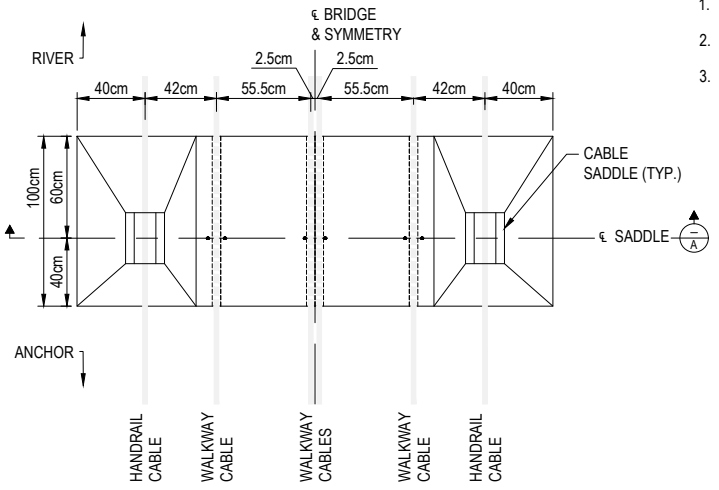

PLAN

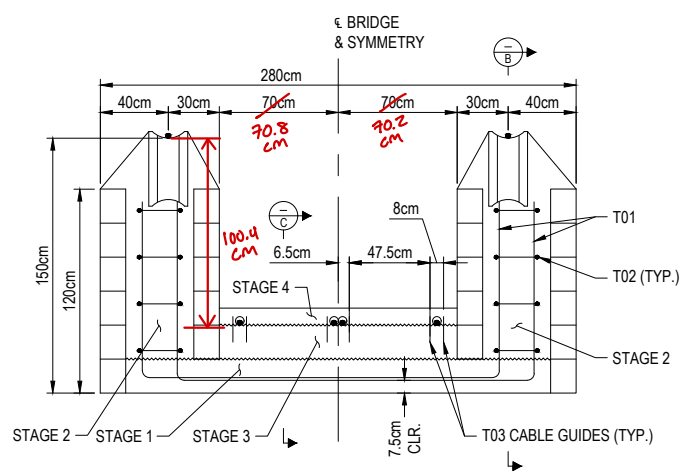


SECTION A


- NOTES:
- SEE ENGINEERS IN ACTION BRIDGE BINDER FOR CONSTRUCTION GUIDELINES.
 - 7.5cm CLEAR COVER SHALL BE PROVIDED FOR ALL REINFORCING AND PLASTIC TUBING.
 - CONSTRUCTION STAGES:
 STAGE 1 - BASE LEVEL MASONRY PERIMETER FILLED WITH CONCRETE.
 STAGE 2 - CONSTRUCT TOWERS IN LIFTS OF 20-40cm.
 STAGE 3 - CAST WALKWAY HUMP AND STAB T03 CABLE GUIDE BARS.
 STAGE 4 - CAST WALKWAY TOPPING SLAB OVER SLEEVED CABLES.

BILL OF MATERIALS				
REINFORCING BARS (PER TOWER)				
NAME	BAR SIZE (mm)	LENGTH (cm)	QUANTITY	LENGTH (m)
T01	16 (#5)	413	4	16.5
T02	10 (#3)	170	8	13.6
T03	10 (#3)	15	6	0.9

ITEM	QUANTITY
CONCRETE	1.08m ³
FLEXIBLE PLASTIC TUBING x 110cm	4

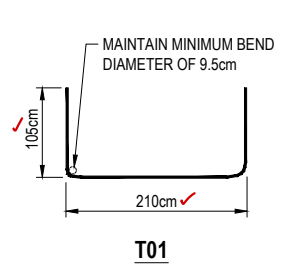


T01

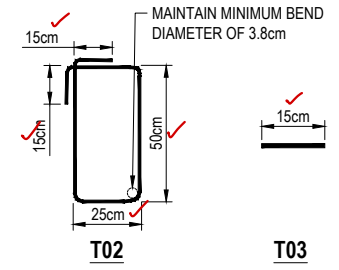


T02


T03

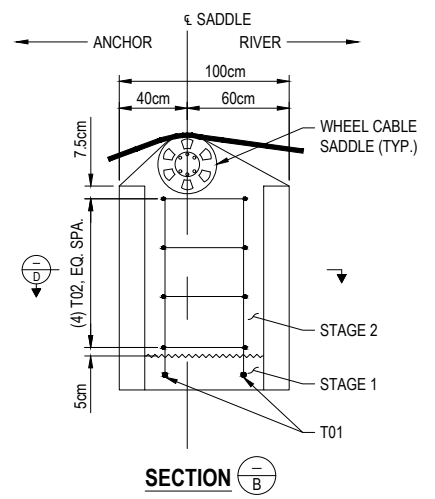

SECTION B

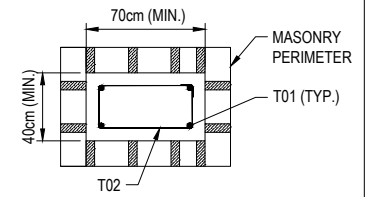

SECTION D

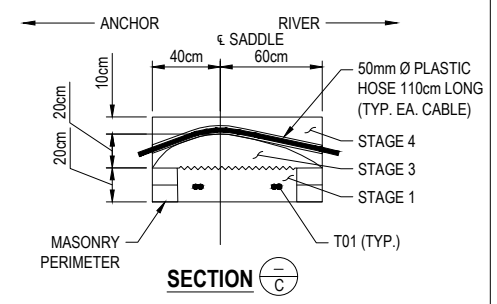

SECTION C



REV.	DESCRIPTION	DATE	ISSUED BY
0	ISSUED FOR CONSTRUCTION	04/11/2022	BKK
1	UPDATED BEND DIM.	10/7/2023	BKK

DISCLAIMER:
 THESE DRAWINGS ARE PRODUCED FOR THE STATED BRIDGE PROJECT. ANY CONDITIONS THAT REQUIRE CHANGES FROM THE PLANS MUST BE COMMUNICATED TO THE ENGINEER FOR APPROVAL PRIOR TO CONSTRUCTION. ANYONE USING THIS PLAN SHOULD VERIFY THE CALCULATIONS ACCORDING TO SITE SPECIFIC CONDITIONS AND LOCAL STANDARDS.

USE OF THESE PLANS FOR ANY OTHER PURPOSE SHALL NOT BE ATTRIBUTABLE TO ENGINEERS IN ACTION AND USERS AGREE TO HOLD ENGINEERS IN ACTION HARMLESS TO ANY AND ALL LIABILITY.

ENGINEERING RECORD
 DATE: 10/7/2023
 DRAWN BY: BKK
 CHECKED BY:
 APPROVED BY:
 REVIEWED BY:

TOWER DETAILS
 FOUR WALKWAY CABLES

DRAWING NUMBER
 T2

RIGHT TOWER

PLAN

NOTES:

- SEE ENGINEERS IN ACTION BRIDGE BINDER FOR CONSTRUCTION GUIDELINES.
- 7.5cm CLEAR COVER SHALL BE PROVIDED FOR ALL REINFORCING AND PLASTIC TUBING.
- CONSTRUCTION STAGES:
 STAGE 1 - BASE LEVEL MASONRY PERIMETER FILLED WITH CONCRETE.
 STAGE 2 - CONSTRUCT TOWERS IN LIFTS OF 20-40cm.
 STAGE 3 - CAST WALKWAY HUMP AND STAB T03 CABLE GUIDE BARS.
 STAGE 4 - CAST WALKWAY TOPPING SLAB OVER SLEEVED CABLES.

BILL OF MATERIALS

REINFORCING BARS (PER TOWER)				
NAME	BAR SIZE (mm)	LENGTH (cm)	QUANTITY	LENGTH (m)
T01	16 (#5)	413	4	16.5
T02	10 (#3)	170	8	13.6
T03	10 (#3)	15	6	0.9

ITEM	QUANTITY
CONCRETE	1.08m ³
FLEXIBLE PLASTIC TUBING x 110cm	4

T01

T02

T03

SECTION A

SECTION B

SECTION C

SECTION D

ENGINEERS IN ACTION

REV.	DESCRIPTION	DATE	ISSUED BY
0	ISSUED FOR CONSTRUCTION	04/11/2022	BKK
1	UPDATED BEND DIM.	10/7/2023	BKK

DISCLAIMER: THESE DRAWINGS ARE PRODUCED FOR THE STATED BRIDGE PROJECT. ANY CONDITIONS THAT REQUIRE CHANGES FROM THE PLANS MUST BE COMMUNICATED TO THE ENGINEER FOR APPROVAL PRIOR TO CONSTRUCTION. ANYONE USING THIS PLAN SHOULD VERIFY THE CALCULATIONS ACCORDING TO SITE SPECIFIC CONDITIONS AND LOCAL STANDARDS.

USE OF THESE PLANS FOR ANY OTHER PURPOSE SHALL NOT BE ATTRIBUTABLE TO ENGINEERS IN ACTION AND USERS AGREE TO HOLD ENGINEERS IN ACTION HARMLESS TO ANY AND ALL LIABILITY.

ENGINEERING RECORD

DATE: 10/7/2023

DRAWN BY: BKK

CHECKED BY:

APPROVED BY:

REVIEWED BY:


TOWER DETAILS

FOUR WALKWAY CABLES

DRAWING NUMBER

T2

NO CHANGE THIS SHEET

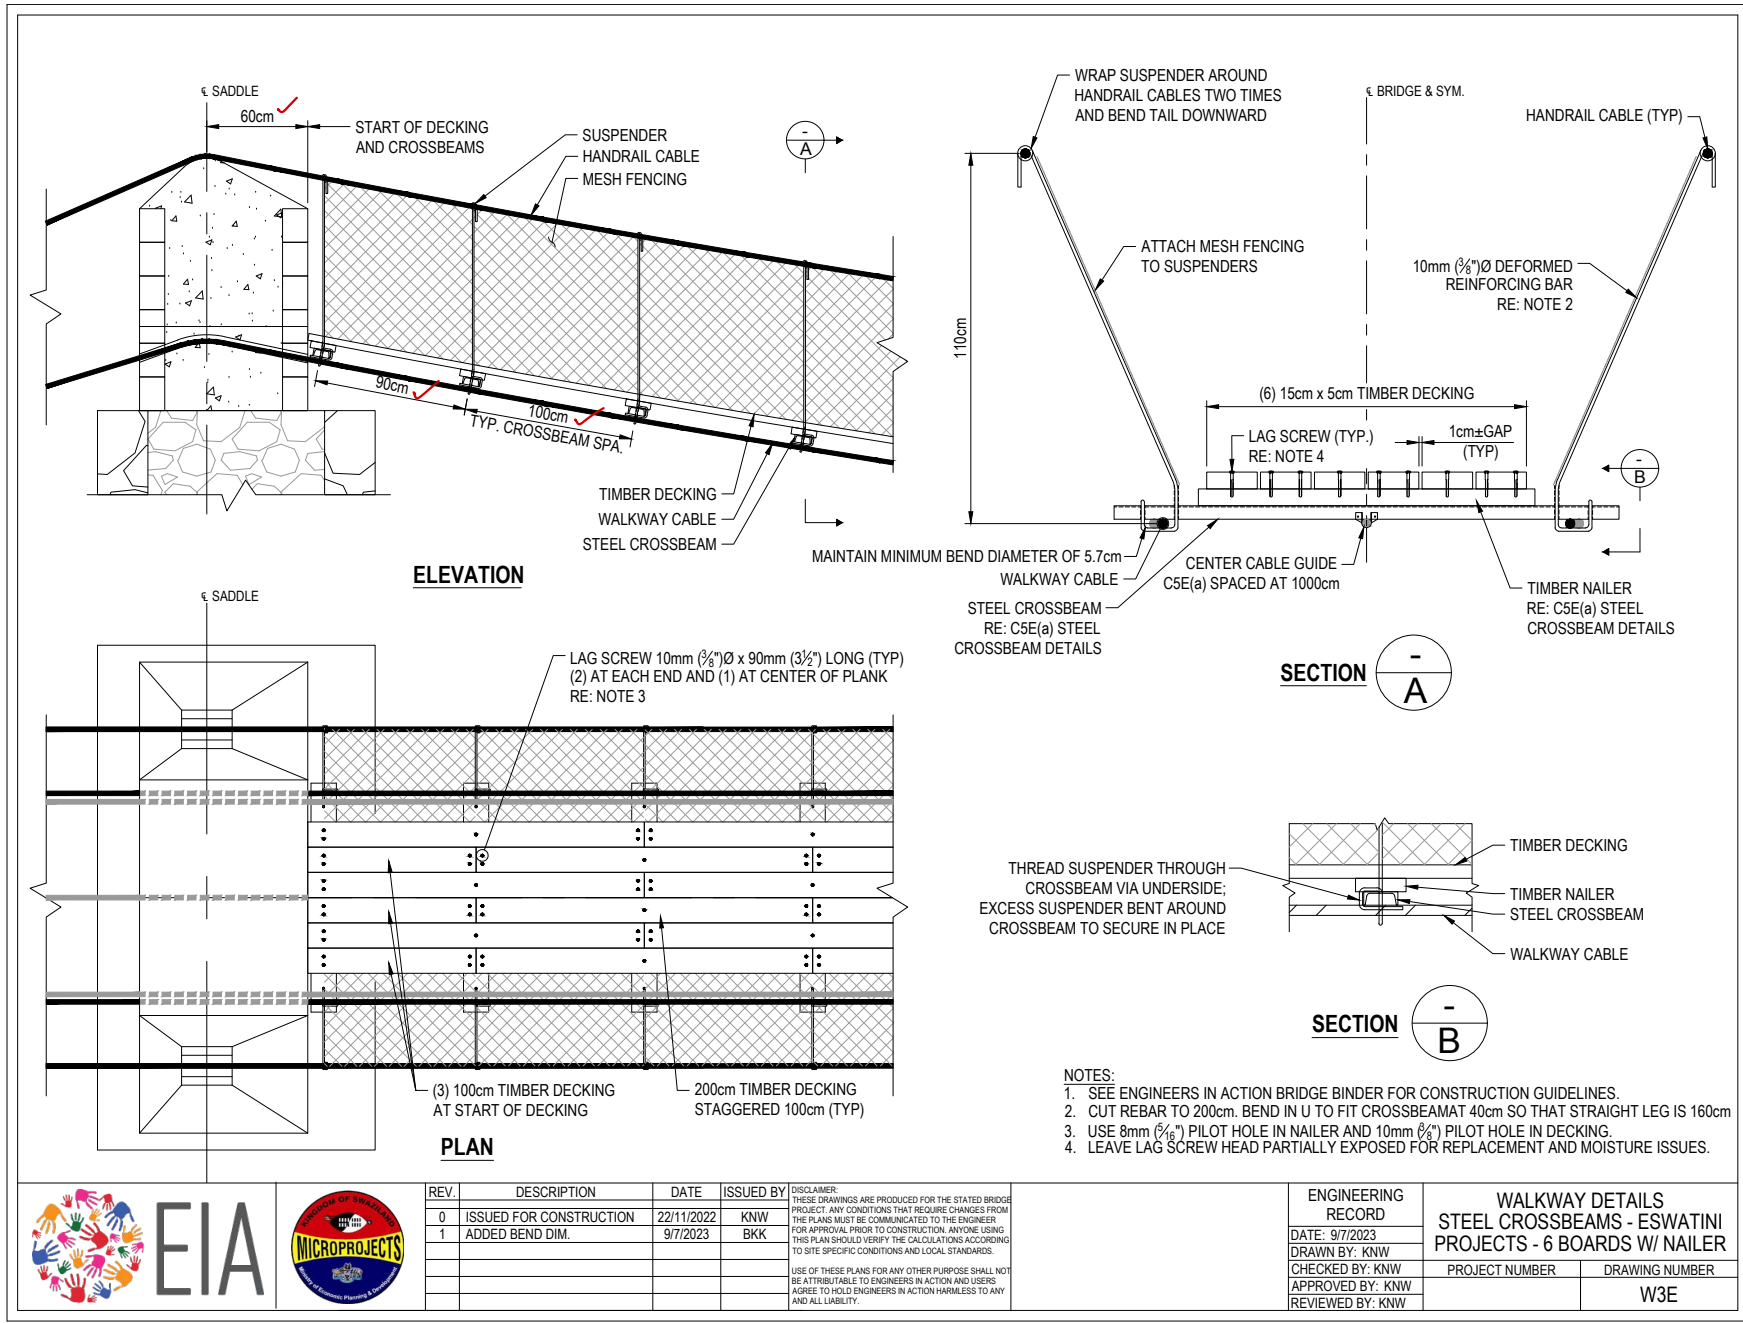


ELEVATION

PLAN

SECTION A

SECTION B

- NOTES:
1. SEE ENGINEERS IN ACTION BRIDGE BINDER FOR CONSTRUCTION GUIDELINES.
 2. CUT REBAR TO 200cm. BEND IN U TO FIT CROSSBEAM AT 40cm SO THAT STRAIGHT LEG IS 160cm
 3. USE 8mm (5/16") PILOT HOLE IN NAILER AND 10mm (3/8") PILOT HOLE IN DECKING.
 4. LEAVE LAG SCREW HEAD PARTIALLY EXPOSED FOR REPLACEMENT AND MOISTURE ISSUES.

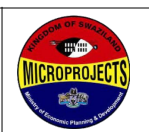

REV.	DESCRIPTION	DATE	ISSUED BY
0	ISSUED FOR CONSTRUCTION	22/11/2022	KNW
1	ADDED BEND DIM.	9/7/2023	BKK






DISCLAIMER:
 THESE DRAWINGS ARE PRODUCED FOR THE STATED BRIDGE PROJECT. ANY CONDITIONS THAT REQUIRE CHANGES FROM THE PLANS MUST BE COMMUNICATED TO THE ENGINEER FOR APPROVAL PRIOR TO CONSTRUCTION. ANYONE USING THIS PLAN SHOULD VERIFY THE CALCULATIONS ACCORDING TO SITE SPECIFIC CONDITIONS AND LOCAL STANDARDS.

USE OF THESE PLANS FOR ANY OTHER PURPOSE SHALL NOT BE ATTRIBUTABLE TO ENGINEERS IN ACTION AND USERS AGREE TO HOLD ENGINEERS IN ACTION HARMLESS TO ANY AND ALL LIABILITY.


ENGINEERING RECORD
DATE: 9/7/2023
DRAWN BY: KNW
CHECKED BY: KNW
APPROVED BY: KNW
REVIEWED BY: KNW

STEEL WALKWAY DETAILS PROJECTS - ESWATINI	
PROJECT NUMBER	DRAWING NUMBER
	W3E

NO CHANGE THIS SHEET

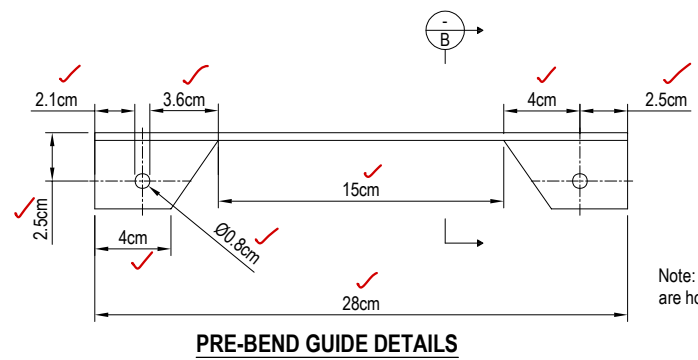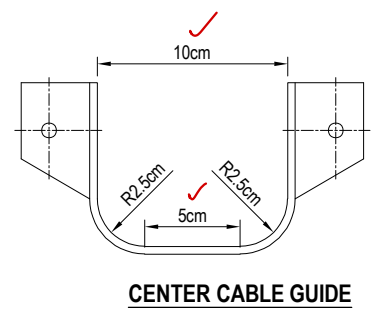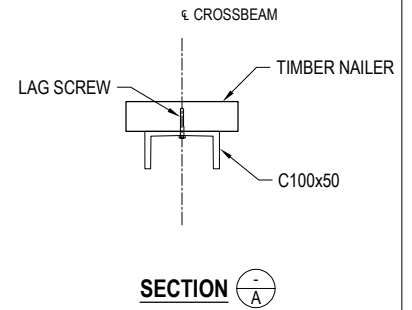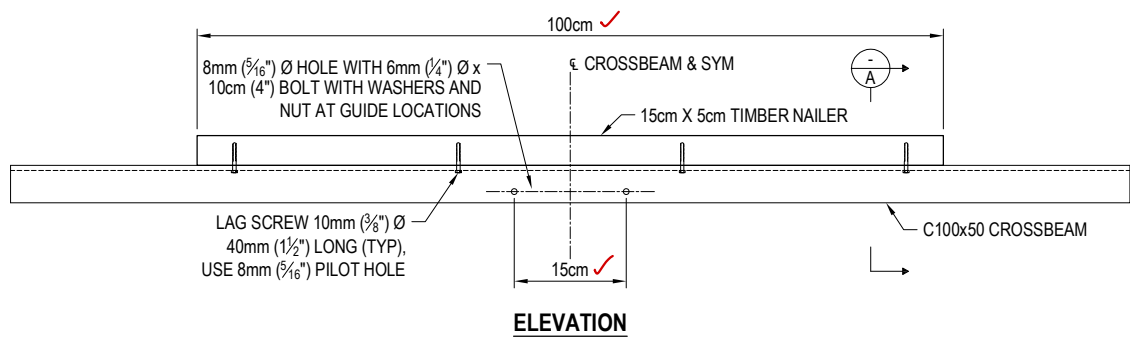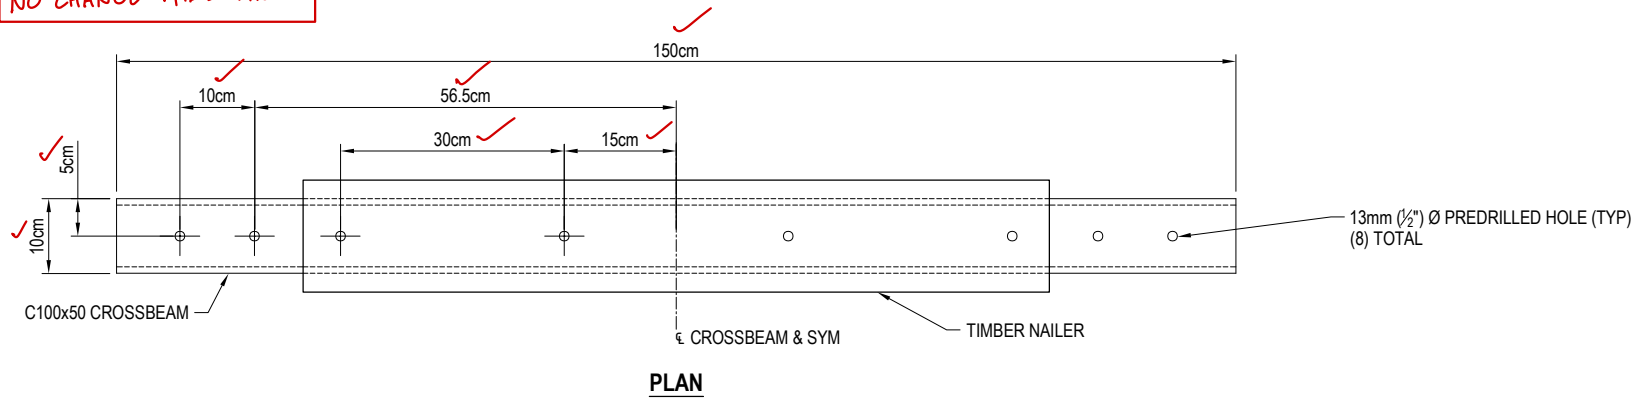

Note: Bent and Pre-Bent Guide are horizontally symmetrical.

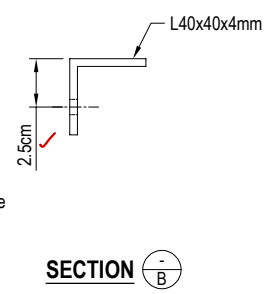

EIA




REV.	DESCRIPTION	DATE	ISSUED BY
0	ISSUED FOR CONSTRUCTION	22/11/2022	KNW
1	LAG SCREW PATTERN UPDATED	01/11/2023	BKK
2	TWO CENTER CABLES UPDATE	13/06/2025	RCS

DISCLAIMER:
 THESE DRAWINGS ARE PRODUCED FOR THE STATED BRIDGE PROJECT. ANY CONDITIONS THAT REQUIRE CHANGES FROM THE PLANS MUST BE COMMUNICATED TO THE ENGINEER FOR APPROVAL PRIOR TO CONSTRUCTION. ANYONE USING THIS PLAN SHOULD VERIFY THE CALCULATIONS ACCORDING TO SITE SPECIFIC CONDITIONS AND LOCAL STANDARDS.
 USE OF THESE PLANS FOR ANY OTHER PURPOSE SHALL NOT BE ATTRIBUTABLE TO ENGINEERS IN ACTION AND USERS AGREE TO HOLD ENGINEERS IN ACTION HARMLESS TO ANY AND ALL LIABILITY.


ENGINEERING RECORD
 DATE: 22/11/2022
 DRAWN BY: KNW
 CHECKED BY: KNW
 APPROVED BY: KNW
 REVIEWED BY: KNW

**STEEL CROSSBEAM DETAILS
 C100x50 - ESWATINI PROJECTS
 W/ CENTER CABLE GUIDE**


PROJECT NUMBER	DRAWING NUMBER
	C5Ea

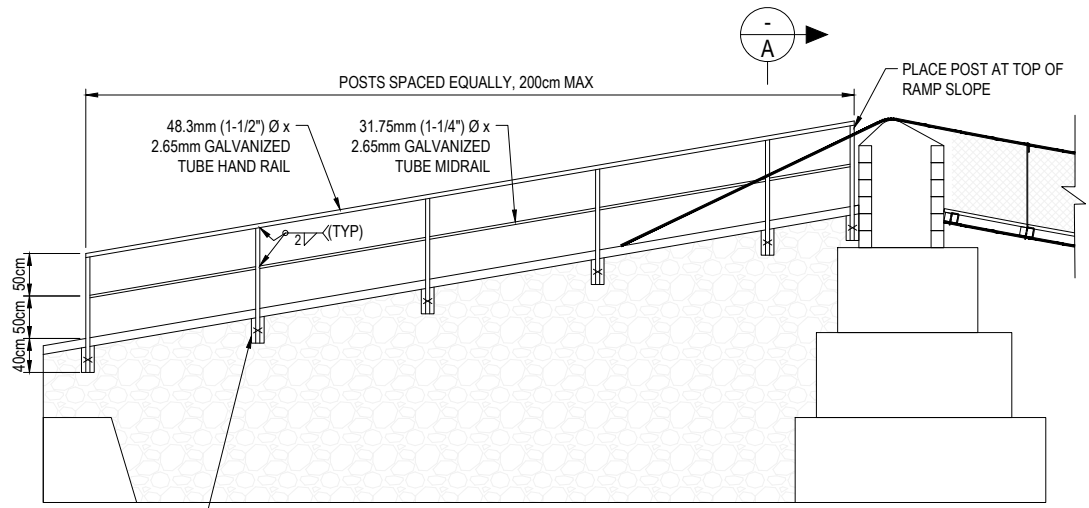


ELEVATION

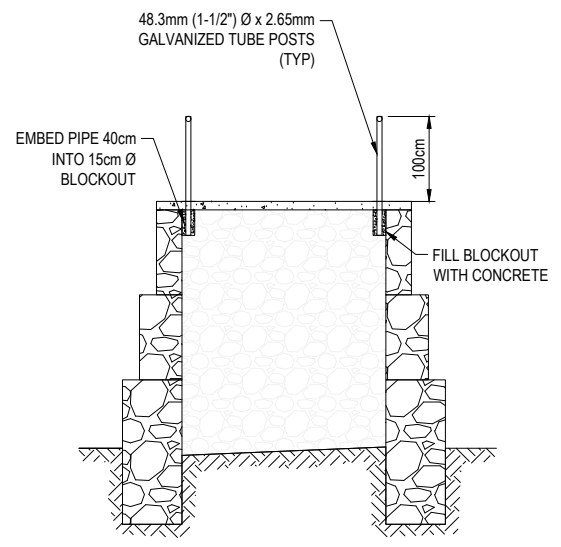

SECTION A-A

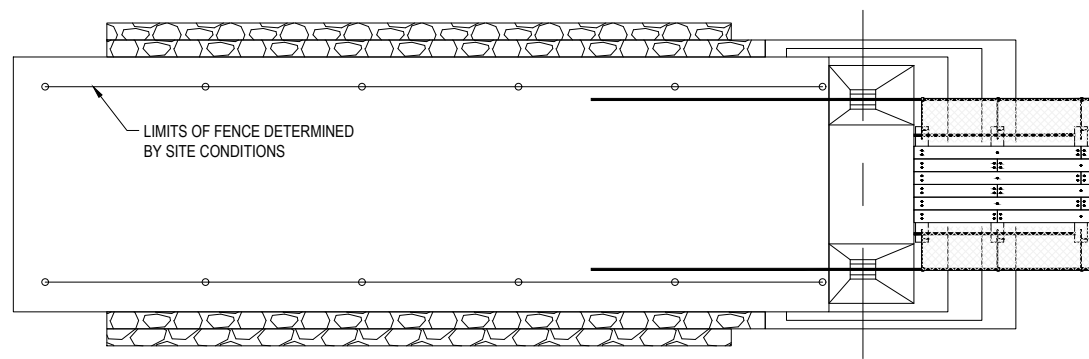

PLAN

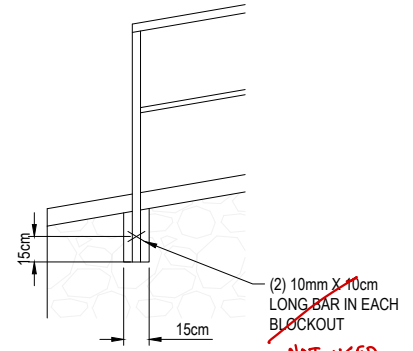

DETAIL 1

- NOTES:**
1. PROVIDE APPROACH RAMP RAIL SYSTEM WHEN THE DISTANCE FROM GRADE TO THE TOP OF THE RAMP CAP EXCEEDS 1.8m (6ft).
 2. APPROACH RAMP RAIL SYSTEM IS NOT REQUIRED WHERE THE VERTICAL DISTANCE IS LESS THAN 1.8m, SUBJECT TO THE PREFERENCE OF COUNTRY MANAGER AND/OR COMMUNITY.
 3. WELD THROAT SIZE IS mm.



REV.	DESCRIPTION	DATE	ISSUED BY
0	ISSUED FOR CONSTRUCTION	18/10/2022	KNW



DISCLAIMER:
THESE DRAWINGS ARE PRODUCED FOR THE STATED BRIDGE PROJECT. ANY CONDITIONS THAT REQUIRE CHANGES FROM THE PLANS MUST BE COMMUNICATED TO THE ENGINEER FOR APPROVAL PRIOR TO CONSTRUCTION. ANYONE USING THIS PLAN SHOULD VERIFY THE CALCULATIONS ACCORDING TO SITE SPECIFIC CONDITIONS AND LOCAL STANDARDS.

USE OF THESE PLANS FOR ANY OTHER PURPOSE SHALL NOT BE ATTRIBUTABLE TO ENGINEERS IN ACTION AND USERS AGREE TO HOLD ENGINEERS IN ACTION HARMLESS TO ANY AND ALL LIABILITY.

ENGINEERING RECORD
DATE: 28/03/2022
DRAWN BY: KNW
CHECKED BY: KNW
APPROVED BY: KNW
REVIEWED BY: KNW

APPROACH RAMP DETAILS
WELDED TUBES
BOLIVIA PROJECTS

PROJECT NUMBER	DRAWING NUMBER
	F3

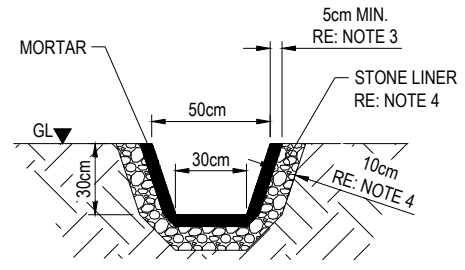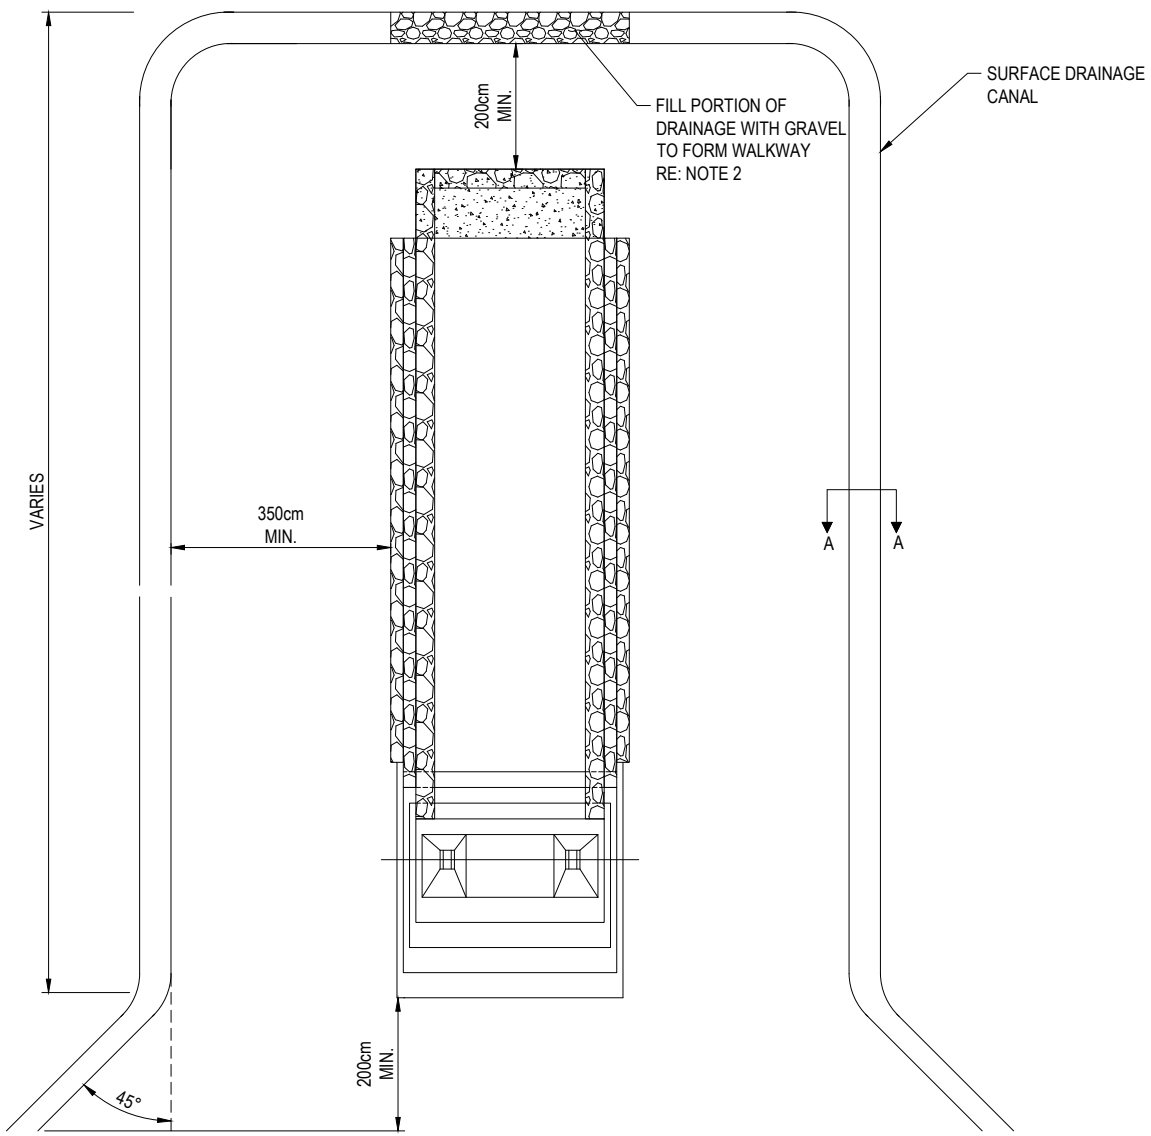

SECTION A-A

- NOTES:
1. DRAINAGE CONSTRUCTION SHOULD BE COMPLETED WITH LEFTOVER MATERIALS WHEN POSSIBLE.
 2. DO NOT FILL DRAINAGE WITH SOIL.
 3. DRAINAGE THICKNESS SHOULD BE A MINIMUM OF 5cm.
 4. LINE CHANNEL WITH SMALL STONES APPROXIMATELY 10cm THICK.
 5. THIS DETAIL IS FOR PLANNING PURPOSES AND USES STANDARD, MINIMUM DIMENSIONS. FIELD CHANGES ARE ACCEPTABLE TO BETTER FIT SITE TOPOGRAPHY.

PLAN



ENGINEERS IN ACTION

REV.	DESCRIPTION	DATE	ISSUED BY	DISCLAIMER
0	ISSUED FOR CONSTRUCTION	11/12/2023	BKK	THESE DRAWINGS ARE PRODUCED FOR THE STATED BRIDGE PROJECT. ANY CONDITIONS THAT REQUIRE CHANGES FROM THE PLANS MUST BE COMMUNICATED TO THE ENGINEER FOR APPROVAL PRIOR TO CONSTRUCTION. ANYONE USING THIS PLAN SHOULD VERIFY THE CALCULATIONS ACCORDING TO SITE SPECIFIC CONDITIONS AND LOCAL STANDARDS.
				USE OF THESE PLANS FOR ANY OTHER PURPOSE SHALL NOT BE ATTRIBUTABLE TO ENGINEERS IN ACTION AND USERS AGREE TO HOLD ENGINEERS IN ACTION HARMLESS TO ANY AND ALL LIABILITY.

ENGINEERING RECORD		SURFACE DRAINAGE STEEP BACKSLOPES >10°	
DATE: 01/11/2023		PROJECT NUMBER	DRAWING NUMBER
DRAWN BY: BKK			D4
CHECKED BY: BEM			
APPROVED BY: BEM			
REVIEWED BY: BKK			